

GENERAL NOTES


- IT SHALL BE THE RESPONSIBLITY OF THE CONTRACTOR TO CLEAR THE AFFECTS EACH UTILITY INCLUDING IRRIGATION LINES AND APPURTENANCES AND AT NO COST TO THE CITY.
- 2. CONSTRUCTION SHALL BE IN ACCORDANCE WITH THE CITY OF RIVERSIDE DEPARTMENT OF PUBLIC WORKS, STANDARD DRAWINGS, AND THE STANDARD SPECIFICATIONS FOR PUBLIC WORKS CONSTRUCTION,
- CONTACTOR IS TO VERIFY EXISTING SEWER ELEVATION PRIOR TO CONSTRUCTION.
- QUANTITIES SHOWN ARE FOR INFORMATION ONLY AND THE CITY OF RIVERSIDE IS NOT RESPONSIBLE FOR THEIR ACCURACY.
- 5. THE SEWER CONTRACTOR SHALL ADJUST MANHOLES TO FINAL GRADE AFTER PAVING IS COMPLETED.
- 6. A PLUG SHALL BE INSTALLED AND WILL REMAIN IN PLACE WHERE THE NEW SEWER CONNECTS WITH THE EXISTING SEWER UNTIL THE NEW SEWER IS ACCEPTED BY THE CITY:
- THE PRIVATE ENGINEER SIGNING THESE PLANS IS RESPONSIBLE FOR ASSURING THE ACCCURACY AND ACCEPTABILITY OF THE WORK HEREON. IN THE EVENT OF DISCREPANCIES ARISING DURING CONSTRUCTION, THE PRIVATE ENGINEER SHALL BE RESPONSIBLE FOR DETERMINING AN ACCEPTABLE SOLUTION AND REVISING THE PLANS FOR APPROVAL BY THE CITY.
- 7. THE CONTRACTOR SHALL CALL IN A LOCATION REQUEST TO UNDERGROUND SERVICE ALERT (USA), PHONE NO. 1-800-422-4133 TWO WORKING DAYS BEFORE DIGGING. NO CONSTRUCTION PERMIT WILL BE ISSUED BY THE PUBLIC WORKS DEPARTMENT INVOLVING EXCAVATION FOR UNDERGROUND FACILITIES UNLESS THE APPLICANT HAS BEEN PROVIDED AN INQUIRY IDENTIFICATION NUMBER BY U.S.A.
- THE PRIVATE ENGINEER PREPARING THESE PLANS SHALL BE RESPONSIBLE FOR PRESERVING OR RE-ESTABLISHING AND REFERENCING SURVEY MONUMENTS DESTROYED, DISTURBED OR BURIED AS A RESULT OF CONSTRUCTION SHOWN HEREON.
- 9. EXISTING 8" N.E.'LY OUTLET SHALL BE PLUGGED AND SEALED PER
- 10. TRENCH BACKFILL AND RESTORATION OF EXISTING SURFACE IMPROVEMENTS SHALL BE IN ACCORDANCE WITH CITY OF RIVERSIDE STANDARD 453.

CONSTRUCTION NOTES

- CONSTRUCT MANHOLE PER CITY OF RIVERSIDE STD. DWG.
- BREAK INTO EXISTING M.H. NORTHWESTERLY AND RE-CONTOUR BASE TO CONFORM WITH ELEVATIONS SHOWN IN PROFILE.

QUANTITY ESTIMATE

BREAK INTO EXISTING M.H., RE-CONTOUR BASE INSTALL 8" V.C.P. SEWER MAIN L.F. INSTALL M. H. PER CITY OF RIVERSIDE STD. 500

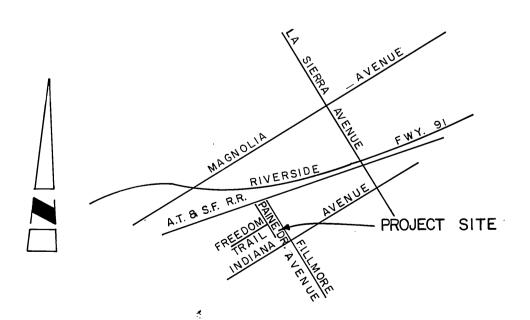

CITY OF RIVERSIDE

VICINITY MAP

NO SCALE

TWO DAYS BEFORE YOU DIG CALL U.S.A. UNDERGROUND ALERT TOLL FREE 1-800-422-4133

BENCH MARK

U.S.C. & G.S. B.M. K-38 1924

DISC IN HEADWALL ON NORTHWEST CORNER OF FILLMORE STREET AND A.T. & S.F. R.R. TRACKS EL 722.010 CITY OF RIVERSIDE WATER SYSTEM:

McCUTCHAN CO., INC.

265 N. SAN GABRIEL BLVD. (818) 795-5162 PASADENA, CALIFORNIA 91107 GERALD E. TUTT R.C.E. 14375

DELETE PROP. SEWER M.H. ____ 12011111211114111 = 40'

INSPECTION 8-8-86 RZE

SEWER PLAN AND PROFILE PAINE DRIVE FILLMORE STREET STORM DRAIN

* As built 8.21.87 74

S-1408

INDEXED P.N.